

#3



IN THE UNITED STATES PATENT AND TRADEMARK OFFICE

Applicants : Jon W. Brown et al.
Application No. : 09/955,750
Filed : September 18, 2001
For : METHODS AND SYSTEMS FOR DYNAMICALLY SERVING IN-STREAM ADVERTISEMENTS

Art Unit : 2681
Docket No. : 100105.401
Date : January 24, 2002

Box Missing Parts
Commissioner for Patents
Washington, DC 20231

REQUEST FOR DRAWING CHANGE

Commissioner for Patents:

Drawing changes, as indicated in red on the attached drawing, are hereby submitted for approval by the Examiner. These changes do not constitute new matter. Also enclosed is a complete set of the formal drawings.

Respectfully submitted,

Jon W. Brown et al.

Seed Intellectual Property Law Group PLLC

Ellen M. Bierman

Registration No. 38,079

EMB:asl

Enclosures:

Postcard
Redlined Figure 10
Formal Drawings

701 Fifth Avenue, Suite 6300
Seattle, Washington 98104-7092
Phone: (206) 622-4900
Fax: (206) 682-6031

D:\NrPortbl\iManage\ANGIEL\251779_1.DOC

20020124 13:55:00

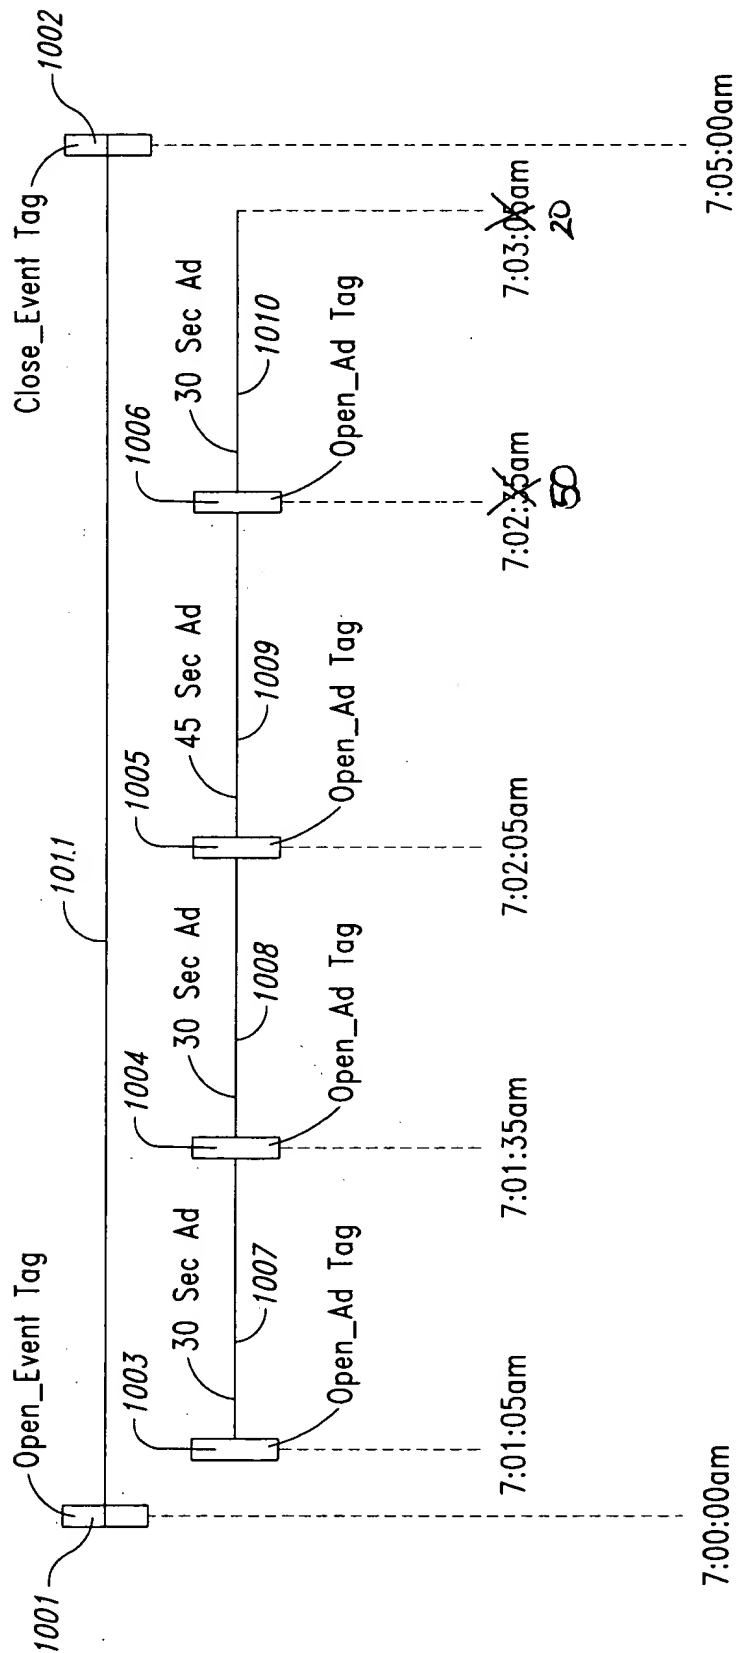


Fig. 10